



CONTRACTOR TO VERIFY ALL DIMENSIONS IN FIELD

1 GROUND FLOOR PLAN
SCALE: 1/8" = 1' - 0"

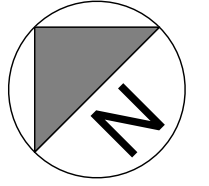


PROJECT:
IRON 23
18 WEST 24TH STREET
NEW YORK NY 10010

DRAWING TITLE:

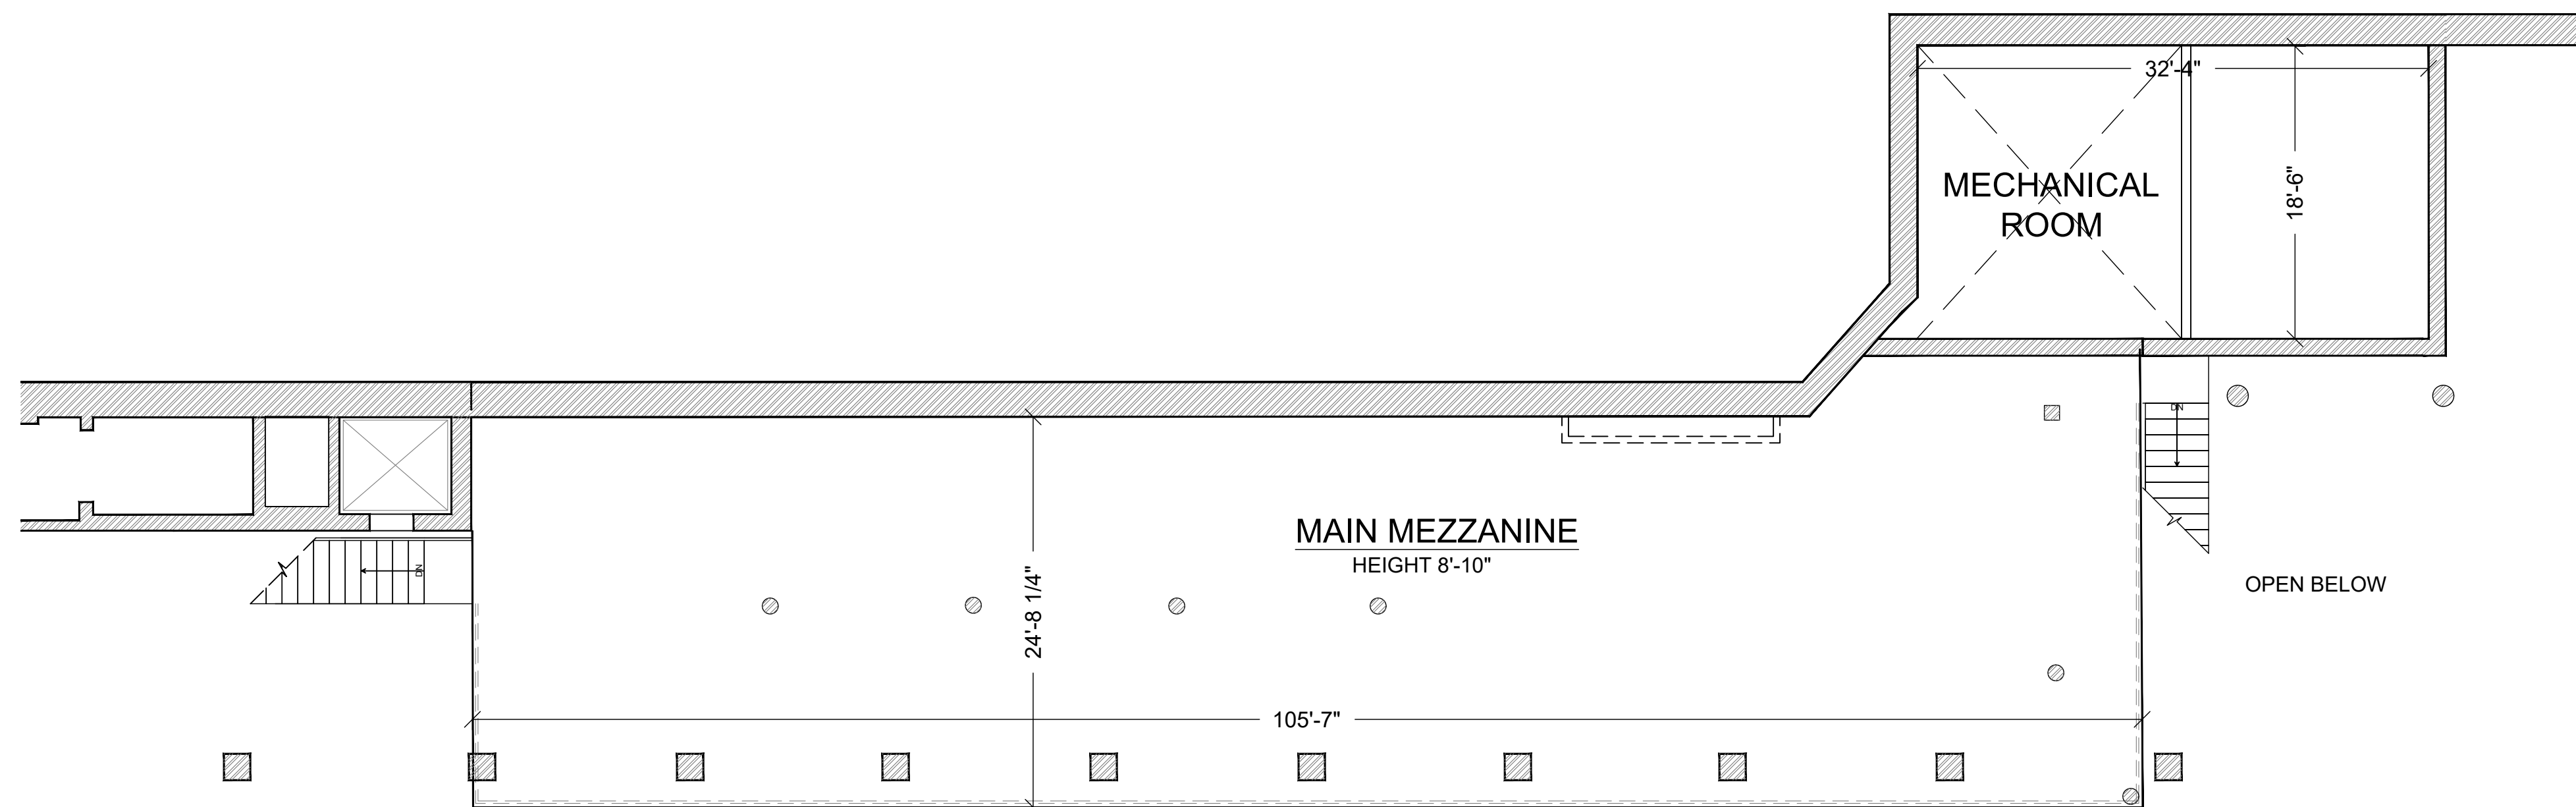

1 MAIN MEZZANINE
SCALE: 1/8" = 1' - 0"

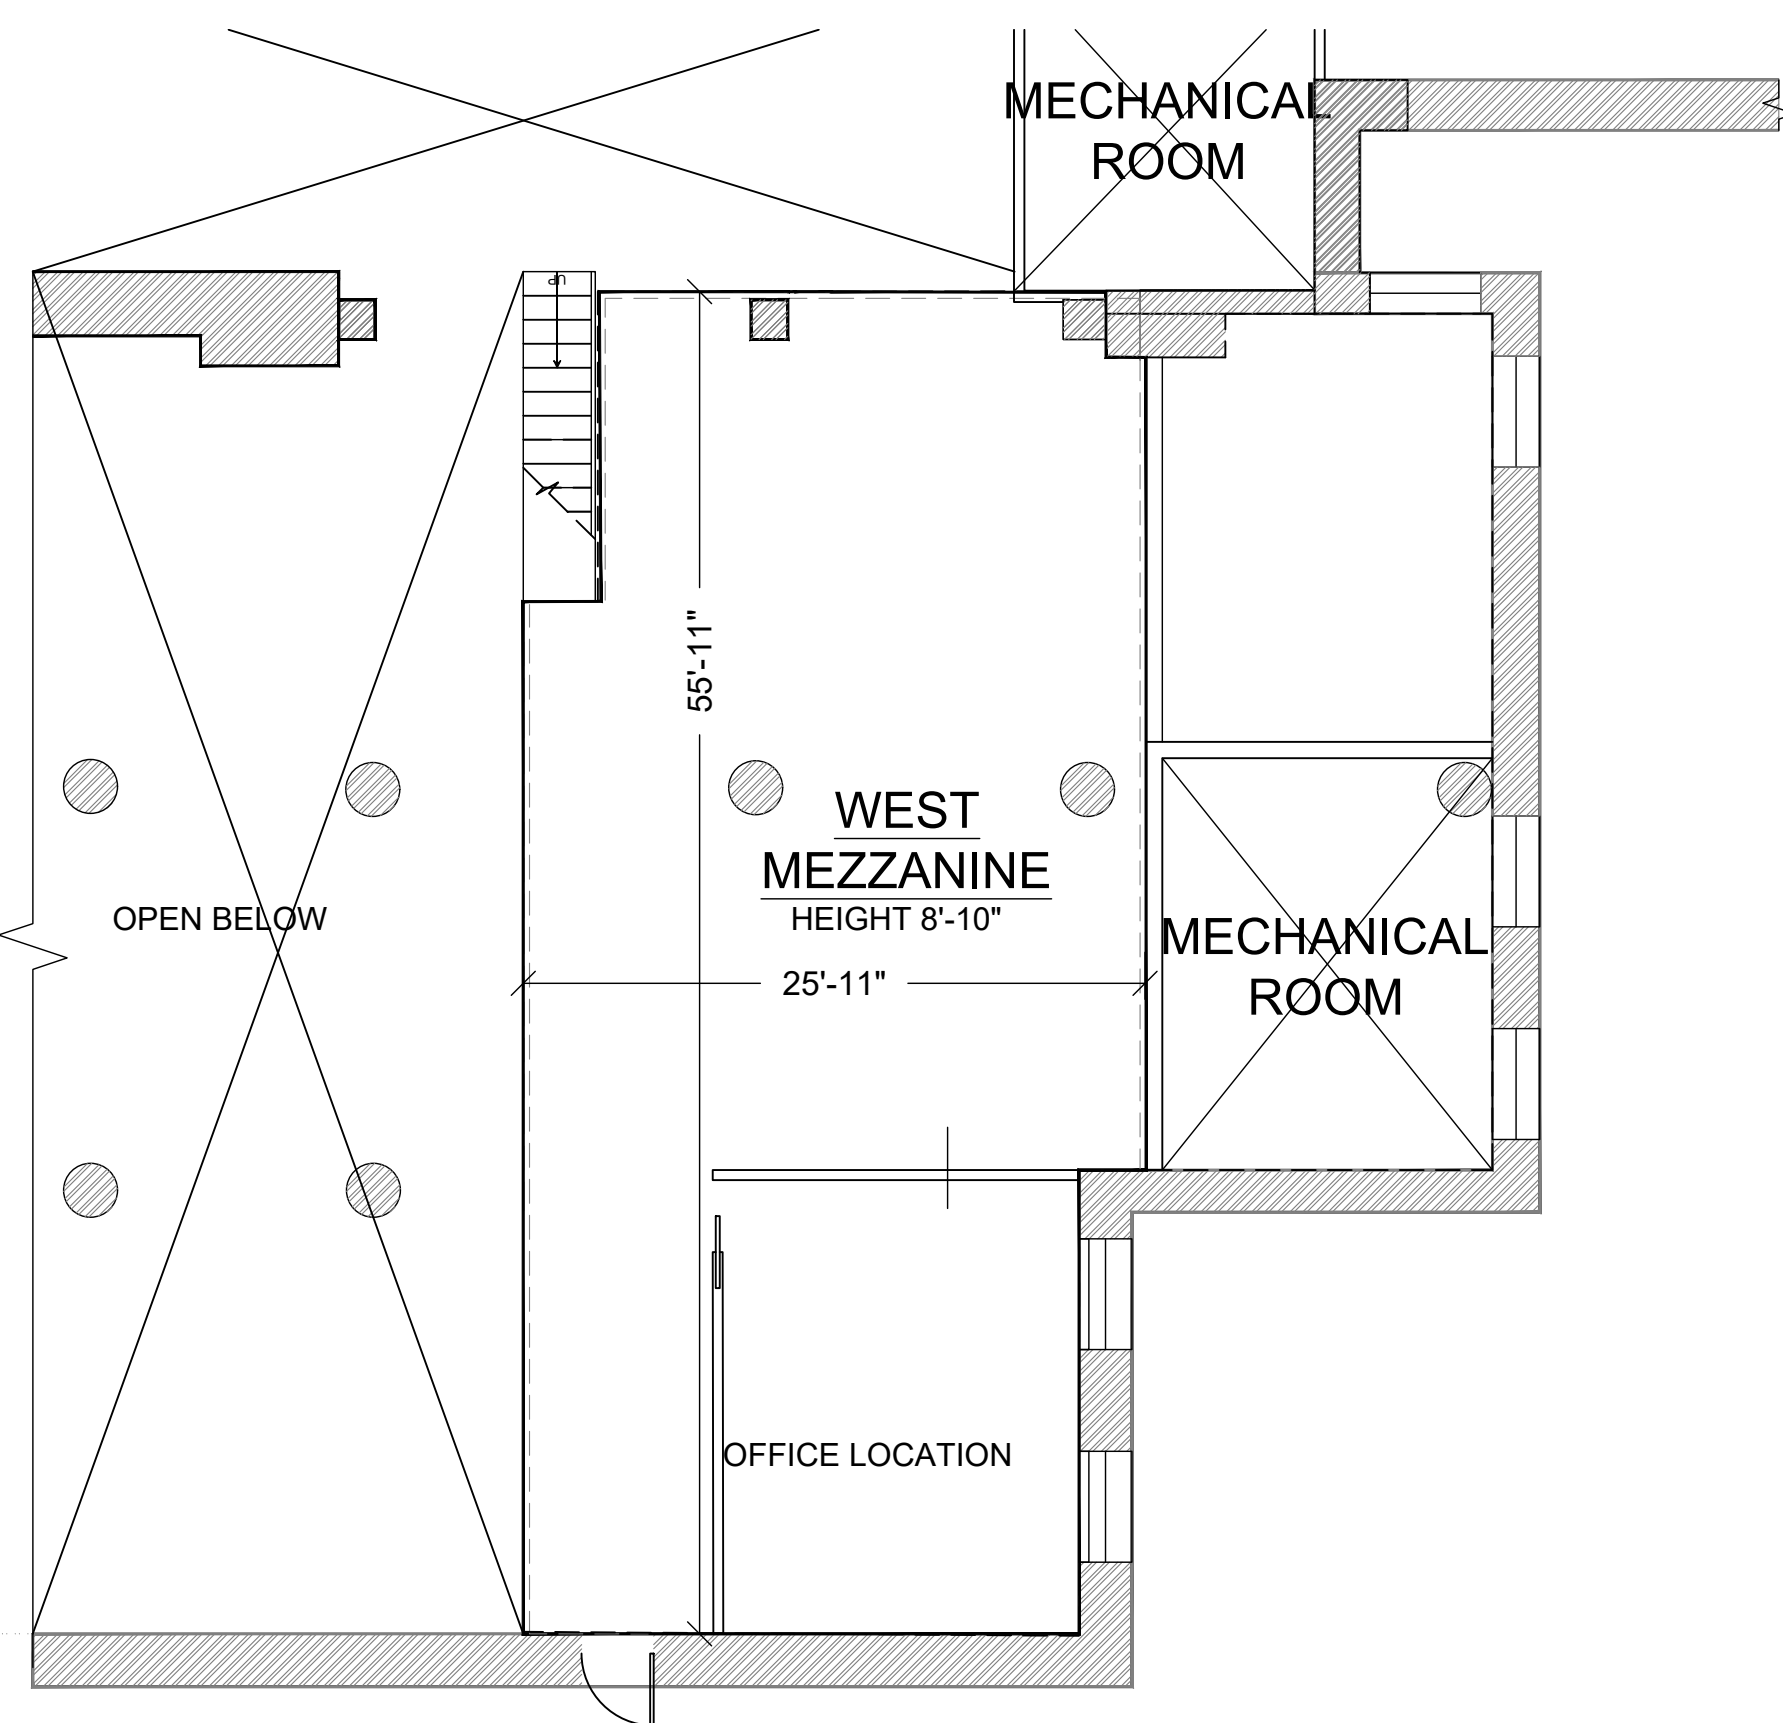

2 WEST MEZZANINE
SCALE: 1/8" = 1' - 0"

PROJECT:
IRON 23
18 WEST 24TH STREET
NEW YORK NY 10010

DRAWING TITLE: