


NOTE:
 1. FLOOR PLANS REFLECT APPROXIMATE DIMENSIONS. VERIFY IN FIELD BEFORE CONFIGURING

2. RENOVATION COMPLETE IS END OF SUMMER 2023


LEGEND	
	LOT LINE
	EXISTING DOOR
	ADJACENT RESIDENTIAL AREA (NO WORK)
	EXIT SIGN
	EXISTING COLUMN
	EXISTING COLUMN



LESSEE:
 ABSOLUTE EVENT SOLUTIONS NYC (AES NYC)
 417 5TH AVENUE, MEZZANINE
 NEW YORK NY 10016
 TEL: 646-398-9100

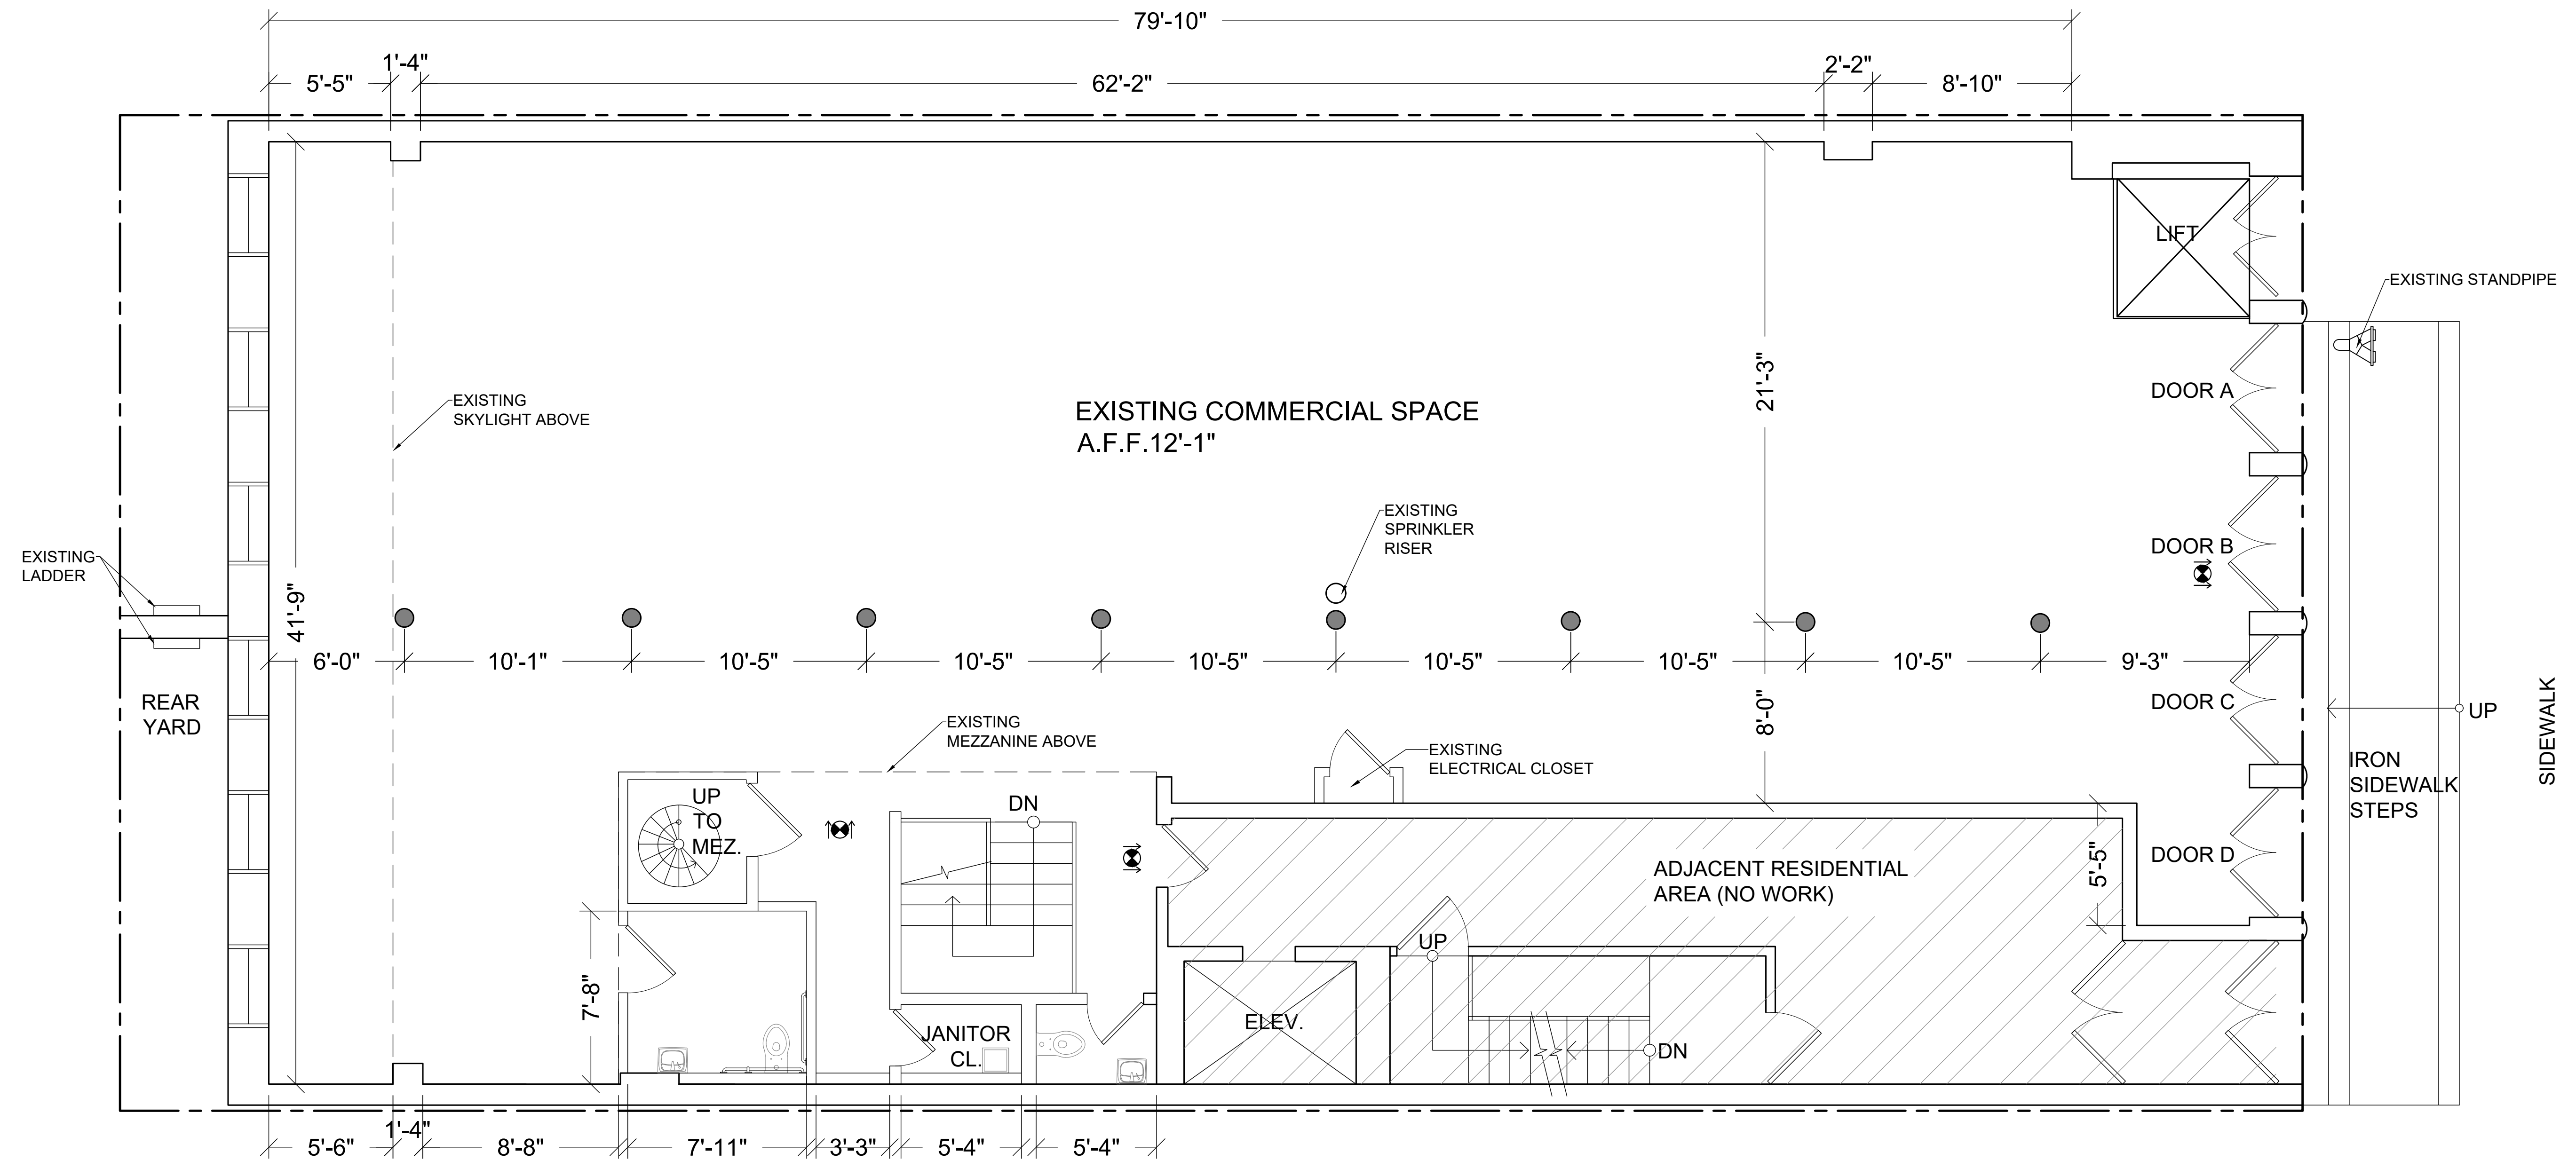

1 FIRST FLOOR AS BUILT
 SCALE: 3/32" = 1' - 0"

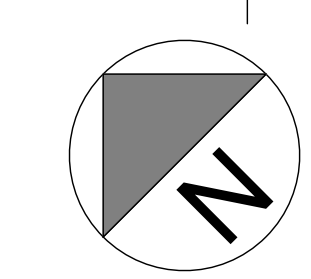

PROJECT:
 21 GREENE STREET
 MANHATTAN NEW YORK, 10013

DRAWING TITLE:
 1ST FLOOR AS BUILT DRAWING

DATE:	4.11.2023
DRAWING BY:	G.D.
CHECK BY:	FU
SCALE:	3/32" = 1' - 0"
JOB NO:	ECC23-0287
DWG NO:	A-100.00
AGENCY NO:	PG NO:
	01 OF 02


NOTE:
 1. FLOOR PLANS REFLECT APPROXIMATE DIMENSIONS. VERIFY IN FIELD BEFORE CONFIGURING

2. RENOVATION COMPLETE IS END OF SUMMER 2023

LEGEND	
	LOT LINE
	EXISTING DOOR
	ADJACENT RESIDENTIAL AREA (NO WORK)
	EXIT SIGN
	EXISTING COLUMN
	EXISTING COLUMN




LESSEE:
 ABSOLUTE EVENT SOLUTIONS NYC (AES NYC)
 417 5TH AVENUE, MEZZANINE
 NEW YORK NY 10016
 TEL: 646-398-9100

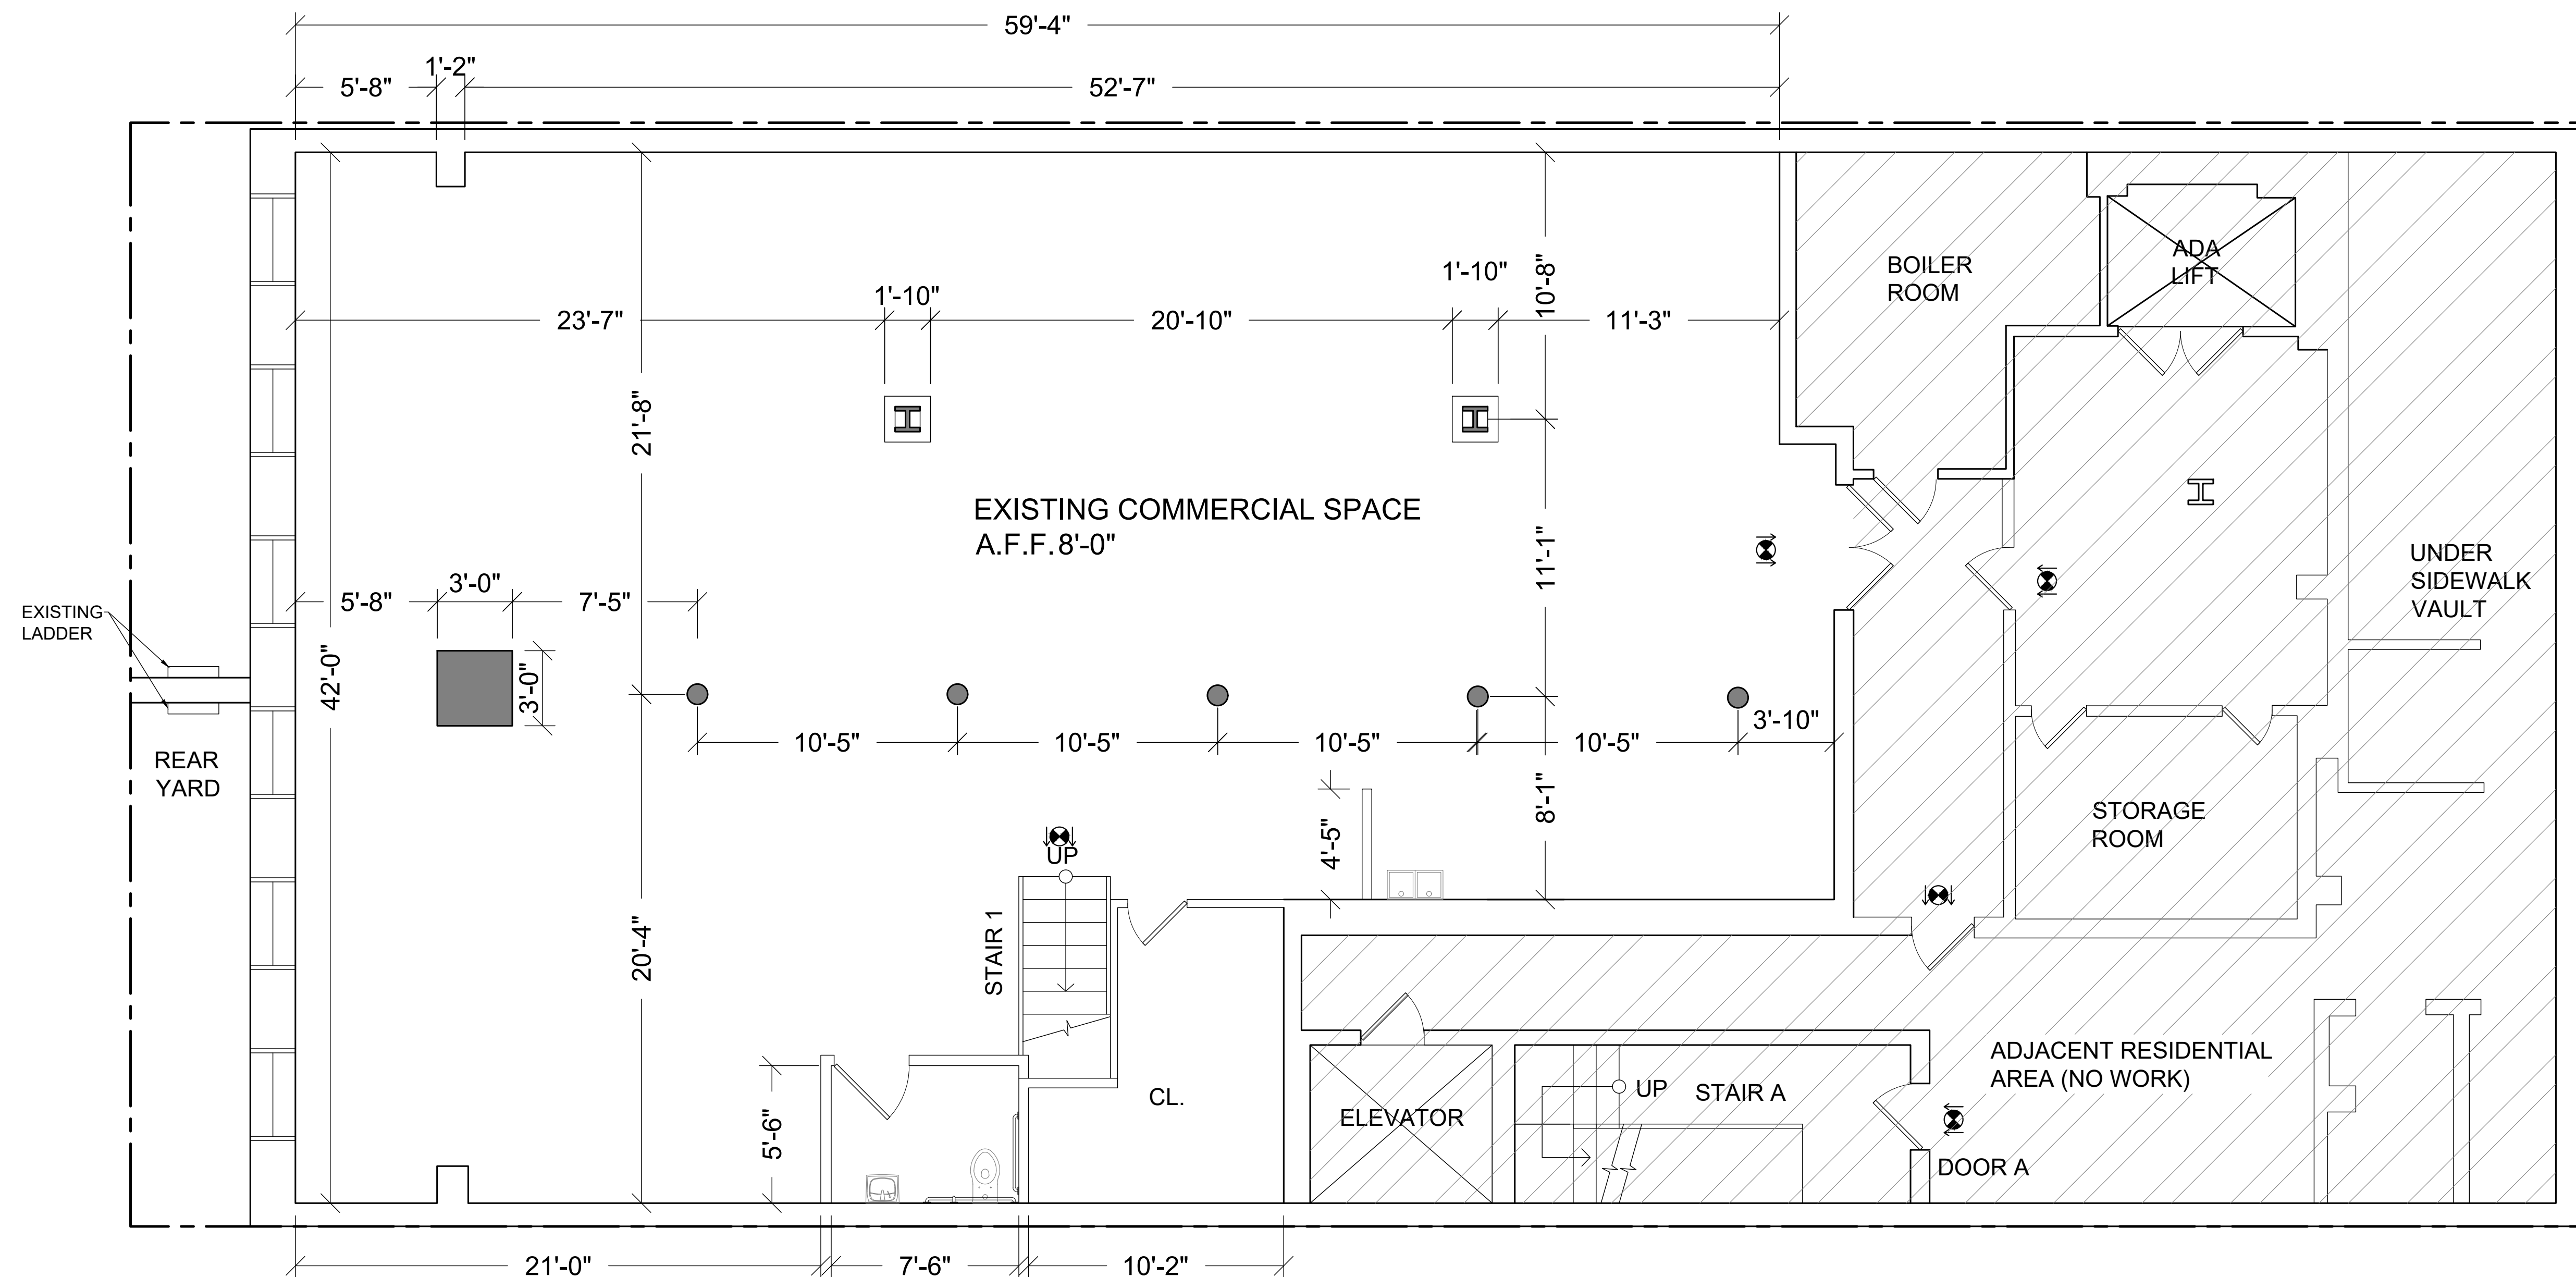

1 CELLAR AS BUILT
 SCALE: 3/32" = 1' - 0"

PROJECT:
 21 GREENE STREET
 MANHATTAN NEW YORK, 10013

DRAWING TITLE:
 CELLAR AS BUILT DRAWING

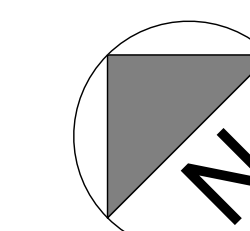

DATE:	4.11.2023
DRAWING BY:	G.D.
CHECK BY:	FU
SCALE:	3/32" = 1' - 0"
JOB NO:	ECC23-0287
DWG NO:	A-101.00
AGENCY NO:	PG NO:
	02 OF 02