



LESSEE:  
 ABSOLUTE EVENT SOLUTIONS NYC (AES NYC)  
 417 5TH AVENUE, MEZZANINE  
 NEW YORK NY 10016  
 TEL: 646-398-9100

LEGEND	
	LOT LINE
	EXISTING DOOR
	ADJACENT RESIDENTIAL AREA (NO WORK)
	EXIT SIGN
	EXISTING COLUMN
	EXISTING COLUMN

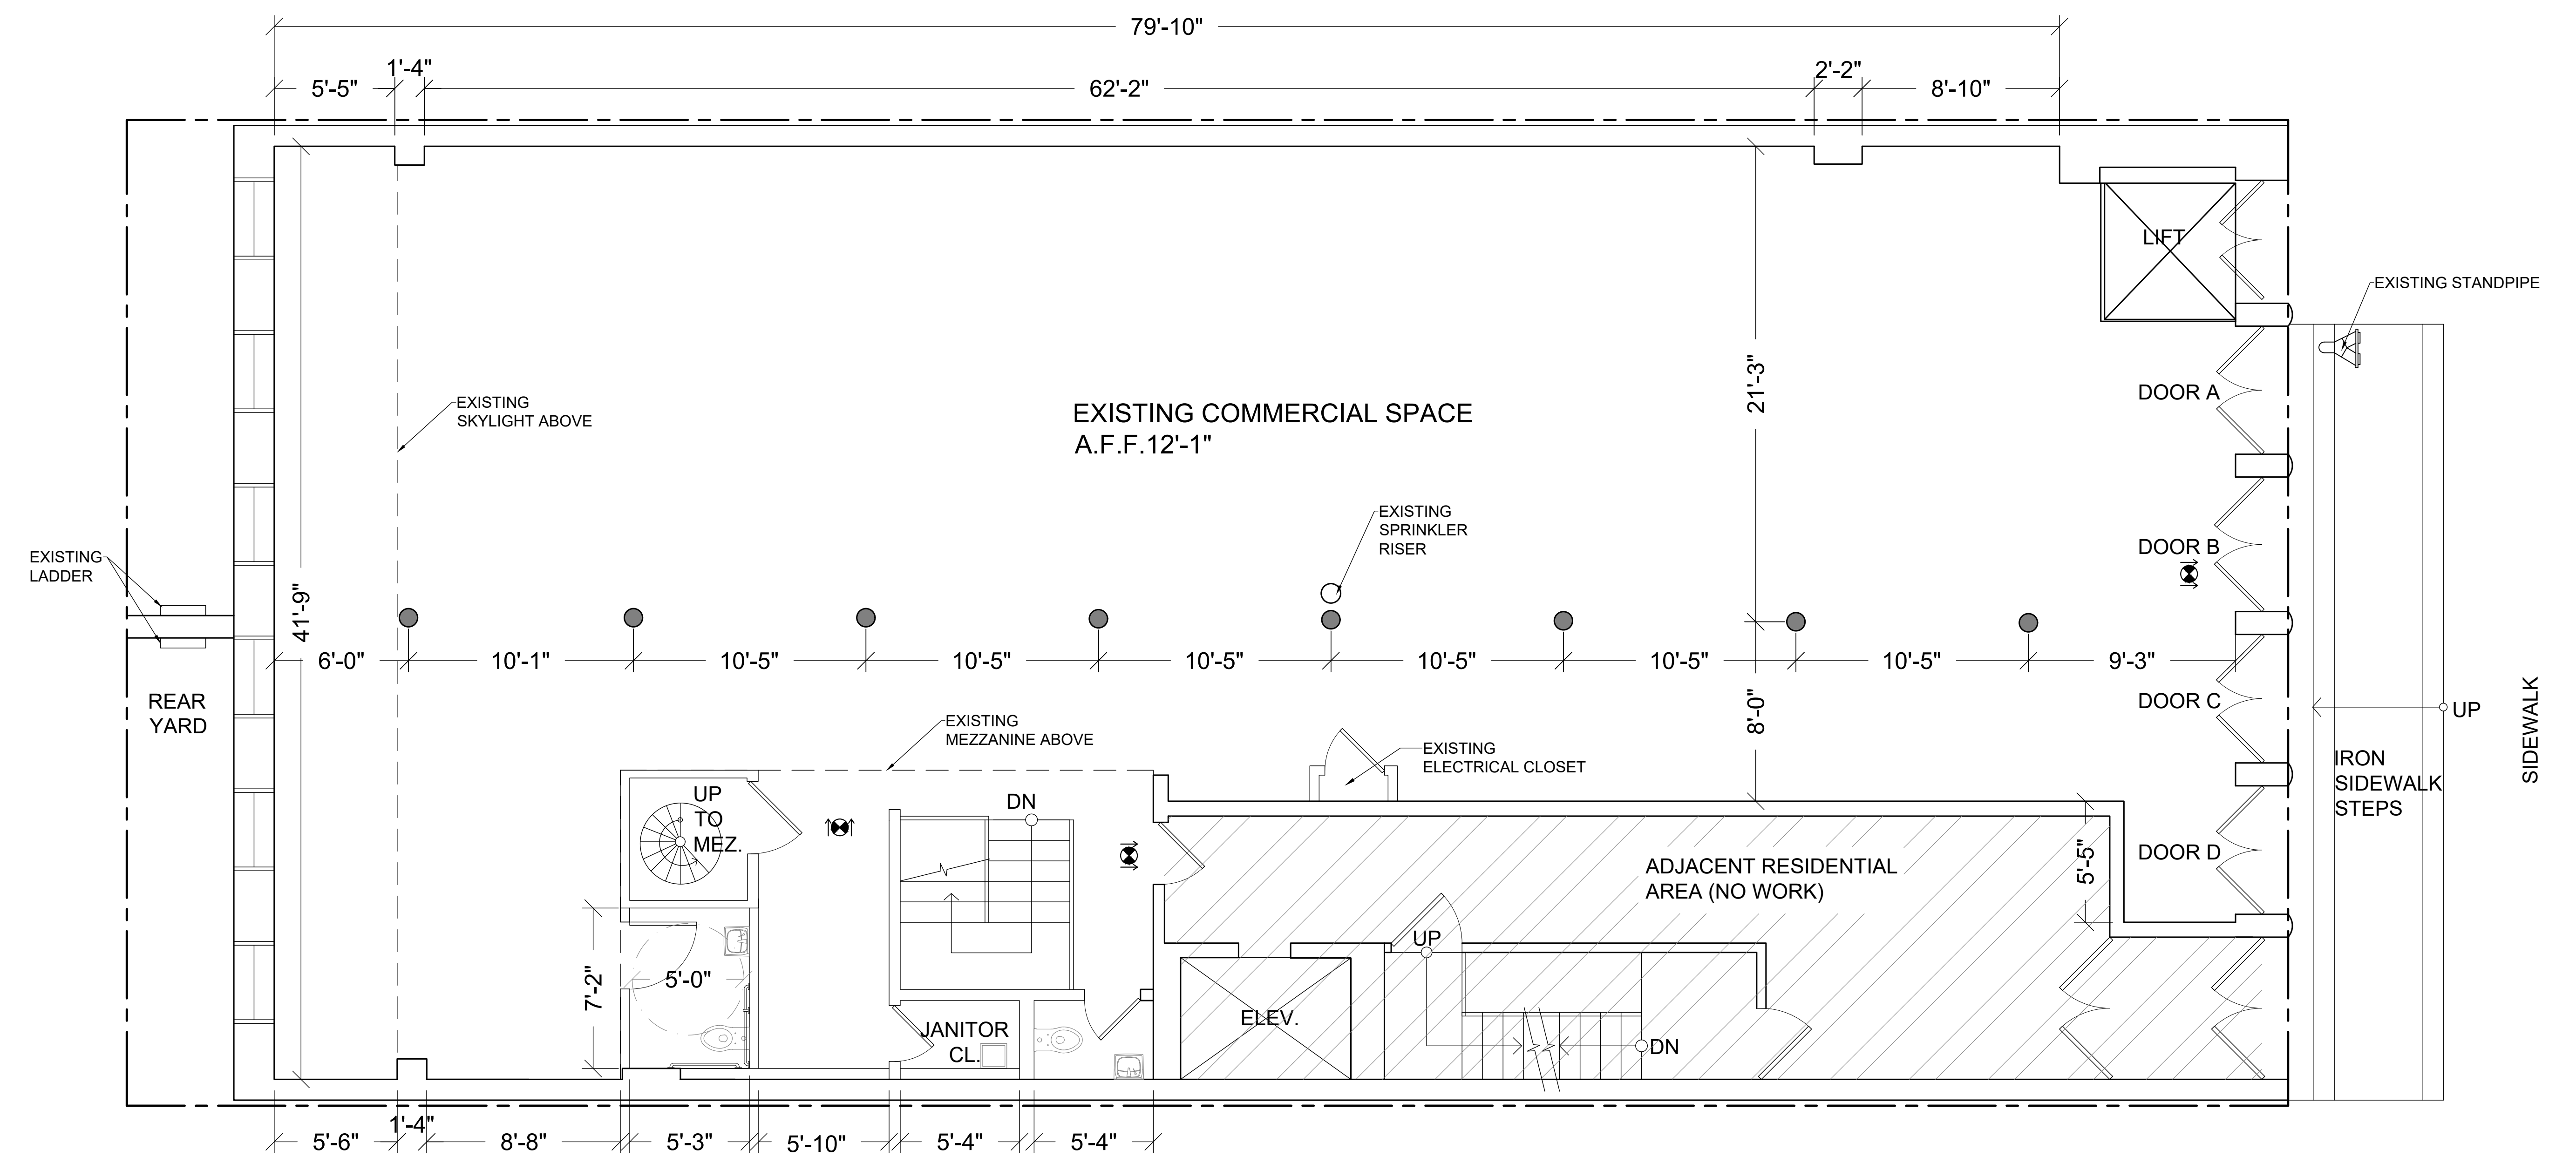

**1 FIRST FLOOR - AS BUILT**  
 SCALE: 1/4" = 1' - 0"


FLOOR PLANS REFLECT APPROXIMATE DIMENSIONS. CONTRACTOR TO VERIFY IN FIELD BEFORE WORK.

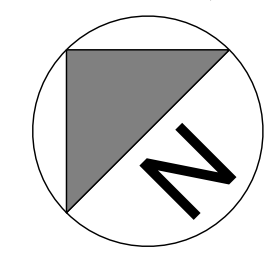

PROJECT:  
 21 GREENE STREET  
 MANHATTAN NEW YORK, 10013  
 AS BUILT DRAWING


DRAWING TITLE:  
 FIRST FLOOR AS BUILT DRAWING

DATE:	7.7.2023
DRAWING BY:	G.D.
CHECK BY:	FU
SCALE:	AS NOTED
JOB NO:	ECC23-0287
DWG NO:	<b>A-100.00</b>
AGENCY NO:	PG NO:
	01 OF 02

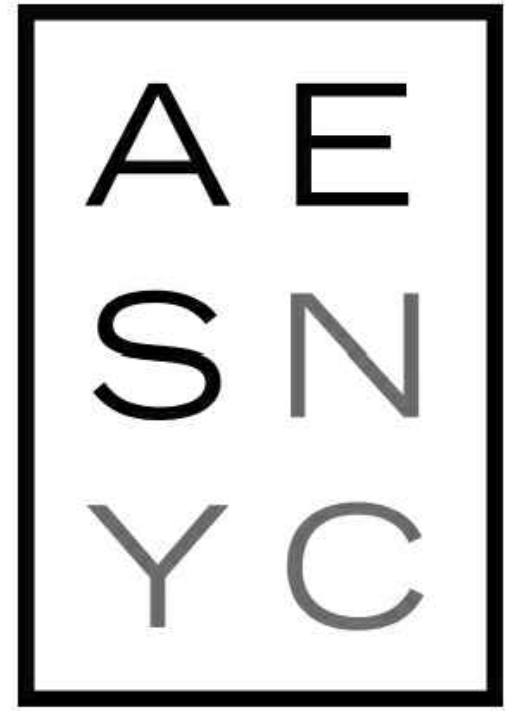

LEGEND	
	LOT LINE
	EXISTING DOOR
	ADJACENT RESIDENTIAL AREA (NO WORK)
	EXIT SIGN
	EXISTING COLUMN
	EXISTING COLUMN

LESSEE:  
 ABSOLUTE EVENT SOLUTIONS NYC (AES NYC)  
 417 5TH AVENUE, MEZZANINE  
 NEW YORK NY 10016  
 TEL: 646-398-9100

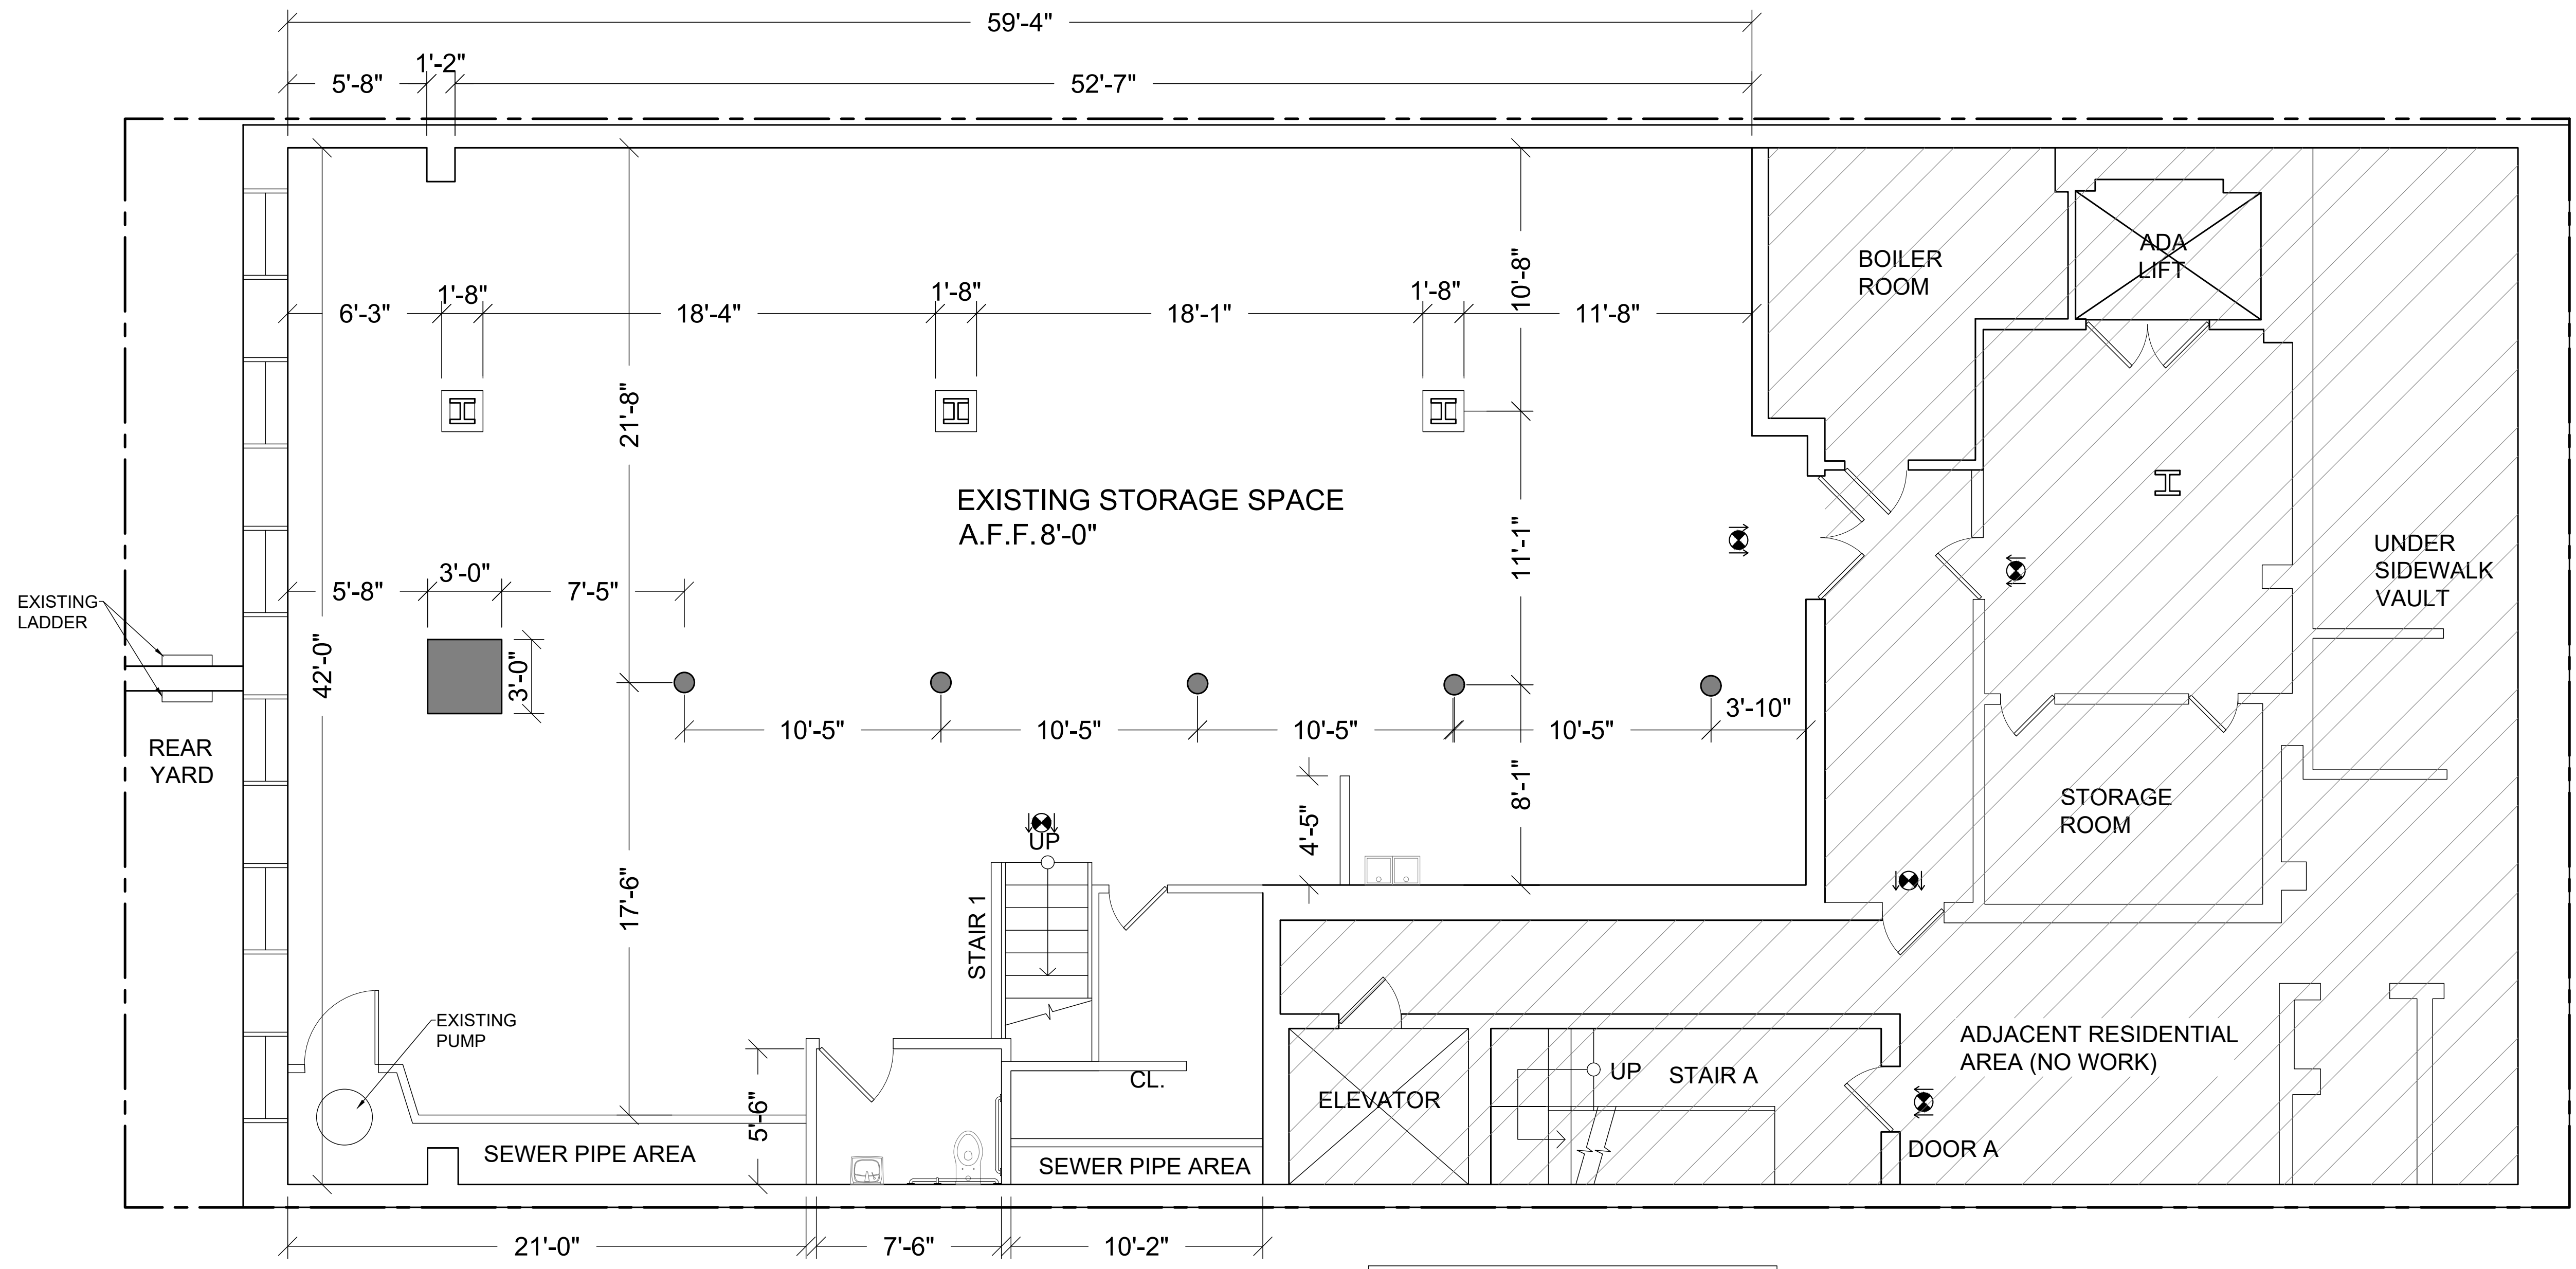


**1 CELLAR PLAN - AS BUILT**  
 SCALE: 1/4" = 1' - 0"

FLOOR PLANS REFLECT APPROXIMATE DIMENSIONS. CONTRACTOR TO VERIFY IN FIELD BEFORE WORK.

PROJECT:  
 21 GREENE STREET  
 MANHATTAN NEW YORK, 10013  
 AS BUILT DRAWING

DRAWING TITLE:  
 CELLAR - AS BUILT DRAWING

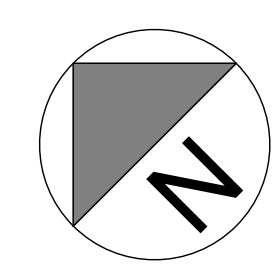

DATE:	7.7.2023
DRAWING BY:	G.D.
CHECK BY:	FU
SCALE:	AS NOTED
JOB NO:	ECC23-0287
DWG NO:	<b>A-101.00</b>
AGENCY NO:	PG NO:
	02 OF 02