


LESSEE:
ABSOLUTE EVENT SOLUTIONS NYC (AES NYC)
417 5TH AVENUE, MEZZANINE
NEW YORK NY 10016
TEL: 646-398-9100

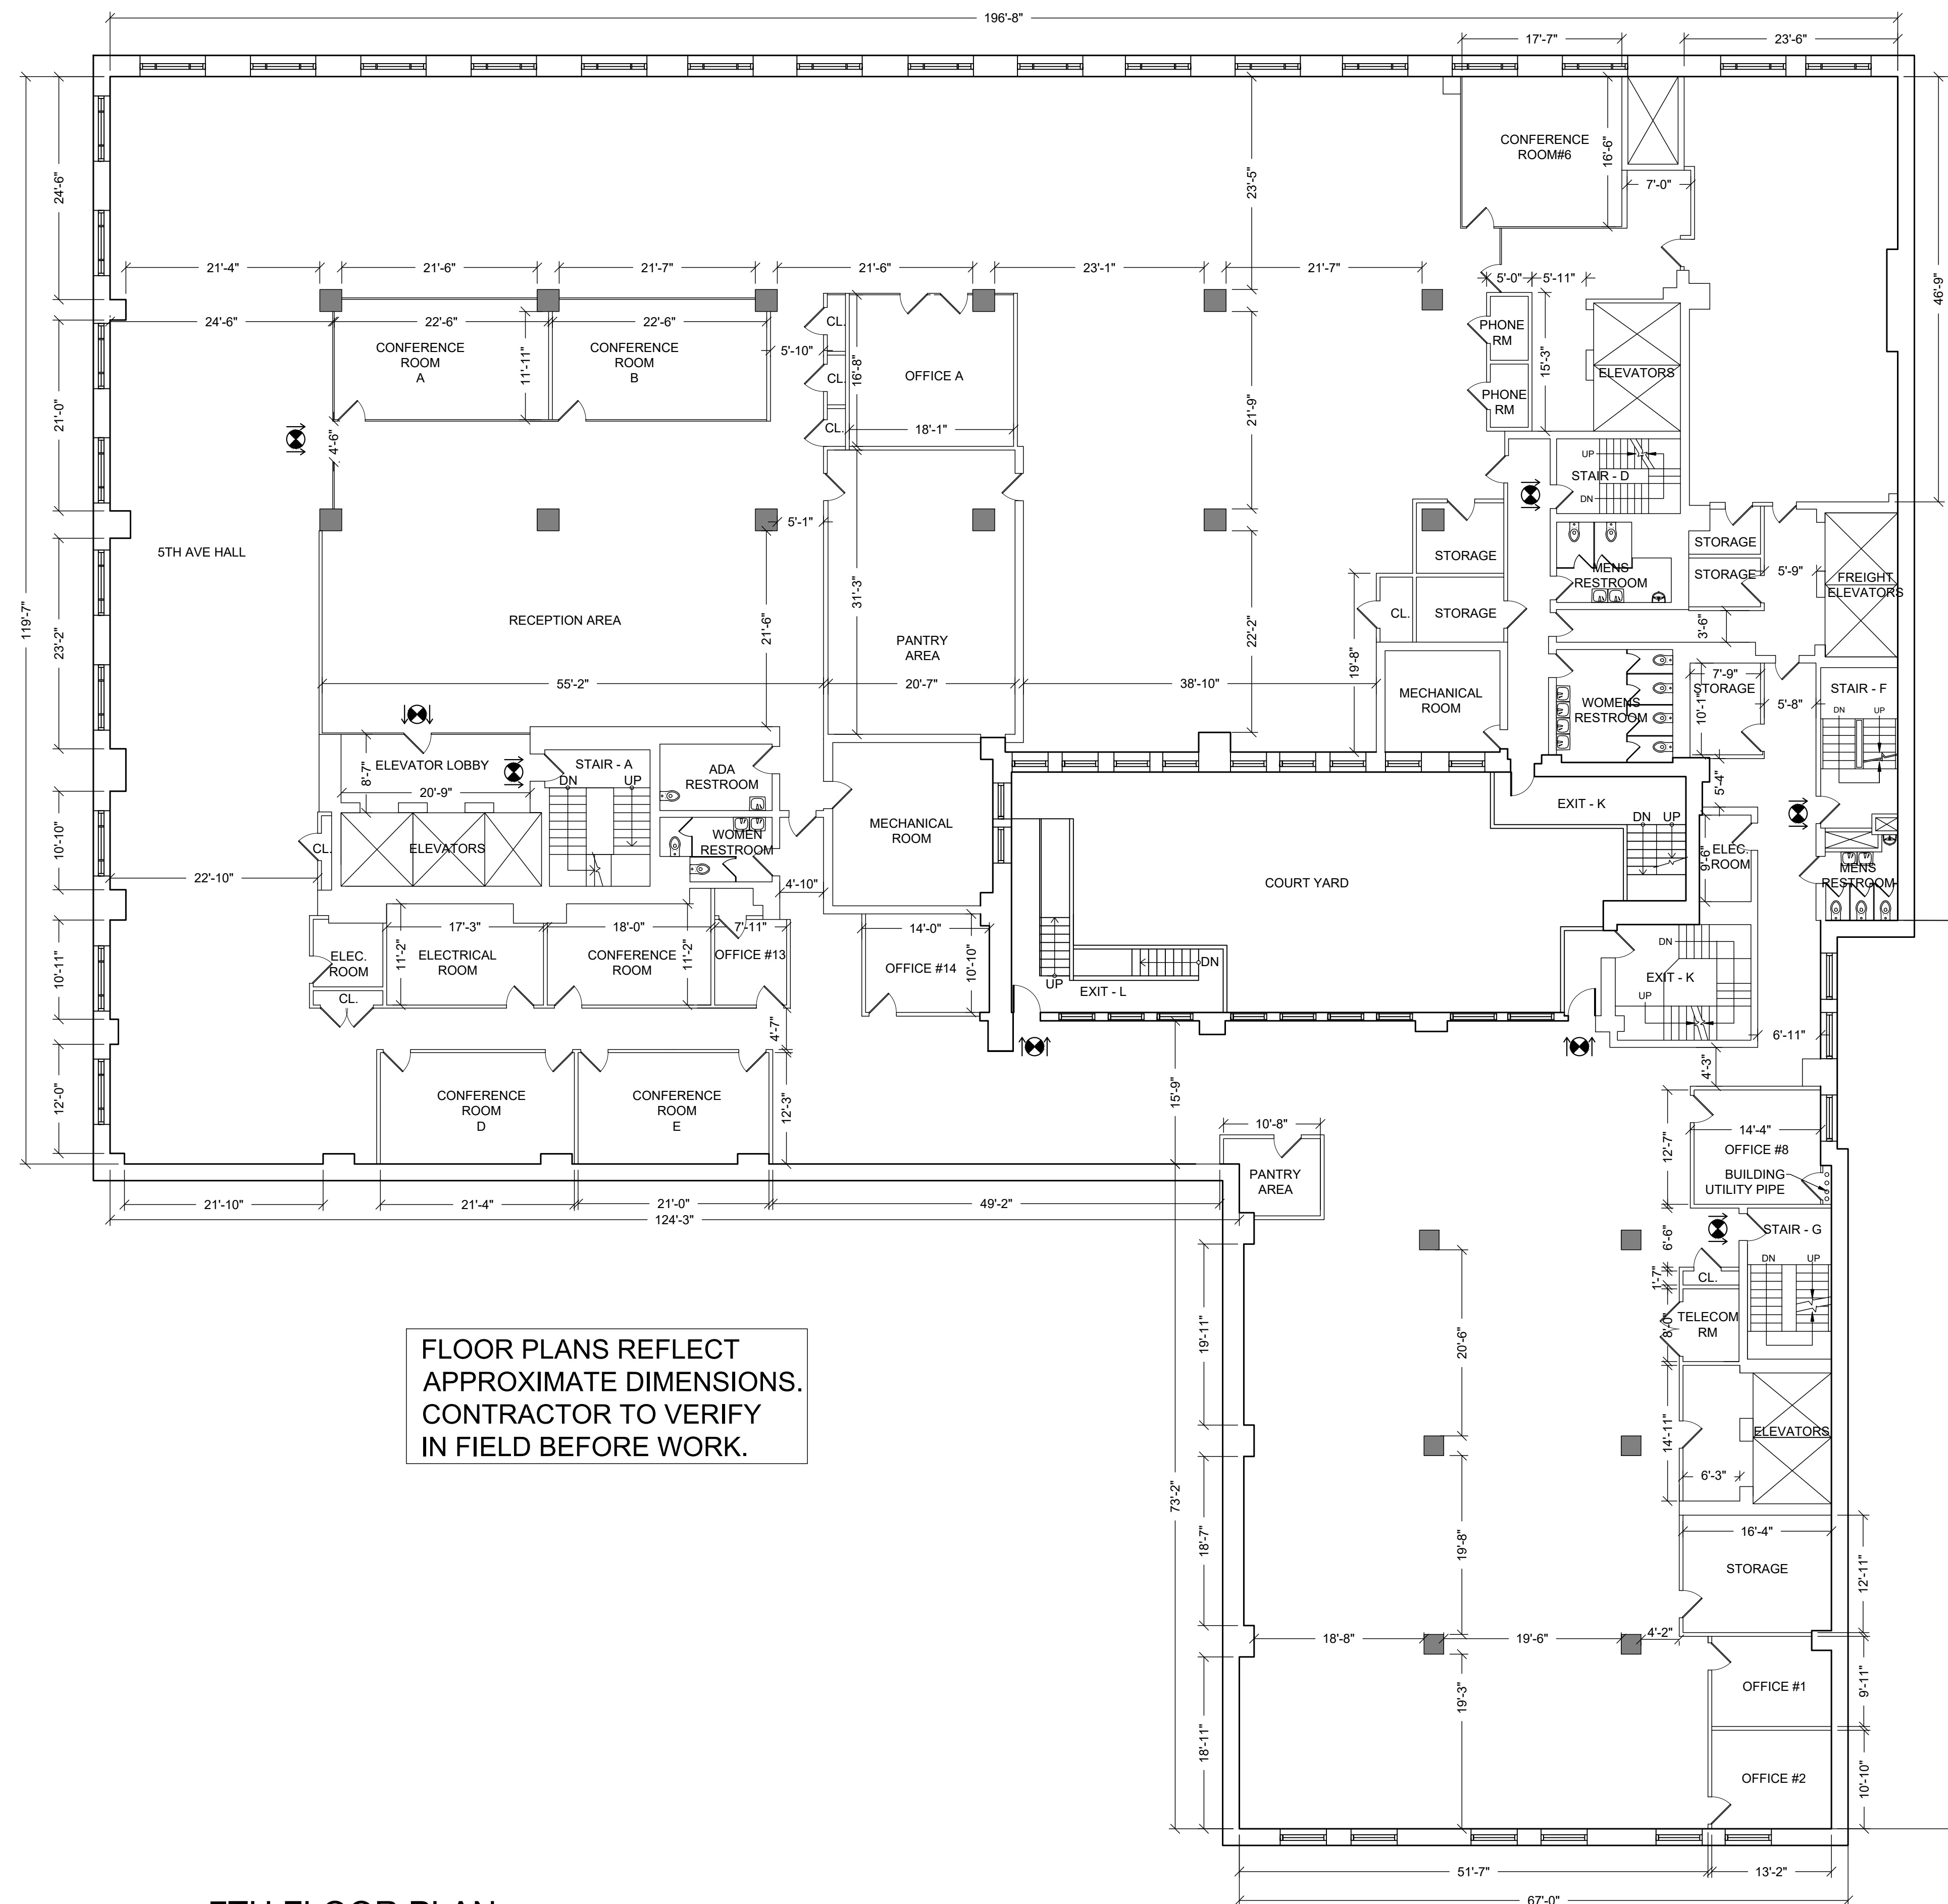

FLOOR PLANS REFLECT APPROXIMATE DIMENSIONS. CONTRACTOR TO VERIFY IN FIELD BEFORE WORK.

1 7TH FLOOR PLAN
SCALE: 3/32" = 1' - 0"

PROJECT:
415 5TH AVENUE
NEW YORK NY 10016

DRAWING TITLE:
7th FLOOR AS BUILT DRAWING

DATE:	1.08.2023
DRAWING BY:	G.D.
CHECK BY:	FU
SCALE:	3/32"=1'-0"
JOB NO:	ECC23-0005
DWG NO:	A-100.00
AGENCY NO:	PG NO:
	01 OF 01